

South Carolina Department of Health and Environmental Control
Office of Ocean and Coastal Resource Management
927 Shine Avenue
Myrtle Beach, South Carolina 29577

March 14, 2014
Permit Application Public Notice

Charles Campbell, OCRM-14-080-S

The Department has received an application for a permit for the alteration of a critical area. The application was submitted pursuant to the Coastal Zone Management Act (Act 123) of 1977 South Carolina General Assembly. The application in brief, is described as follows:

LOCATION: On and adjacent to Murrells Inlet at 4079 Hwy 17 Business, Murrells Inlet, Georgetown County, South Carolina.
TMS: 41-0114-115-00-80.

WORK: The work as proposed consists of constructing a deck at the existing Dead Dog Saloon Restaurant. Specifically, the applicant seeks to build a 30' 9" x 6' 11" and 57'6" x 7' 6", 588 sq ft deck addition that will be used for customer seating. The work as described is for seating at an existing restaurant.


This public notice is being distributed to all known interested persons and agencies to assist in developing facts on which a decision by the Department can be based. Comments concerning the proposed work must be submitted in writing, setting forth sufficient detail to furnish a clear understanding of the reasons for support or opposition.

Comments regarding this application must be received by the Department on or before **April 13, 2014**. For more information, please contact:
Chris Stout at 843-238-4528 or via email at stoutcm@dhec.sc.gov.



NOTE: Plans depicting the proposed work are available and will be provided upon receipt of a written request or may be viewed on the Department website at www.scdhec.gov/environment/ocrm/public_notice.htm.



EXISTING SIDE ELEVATION

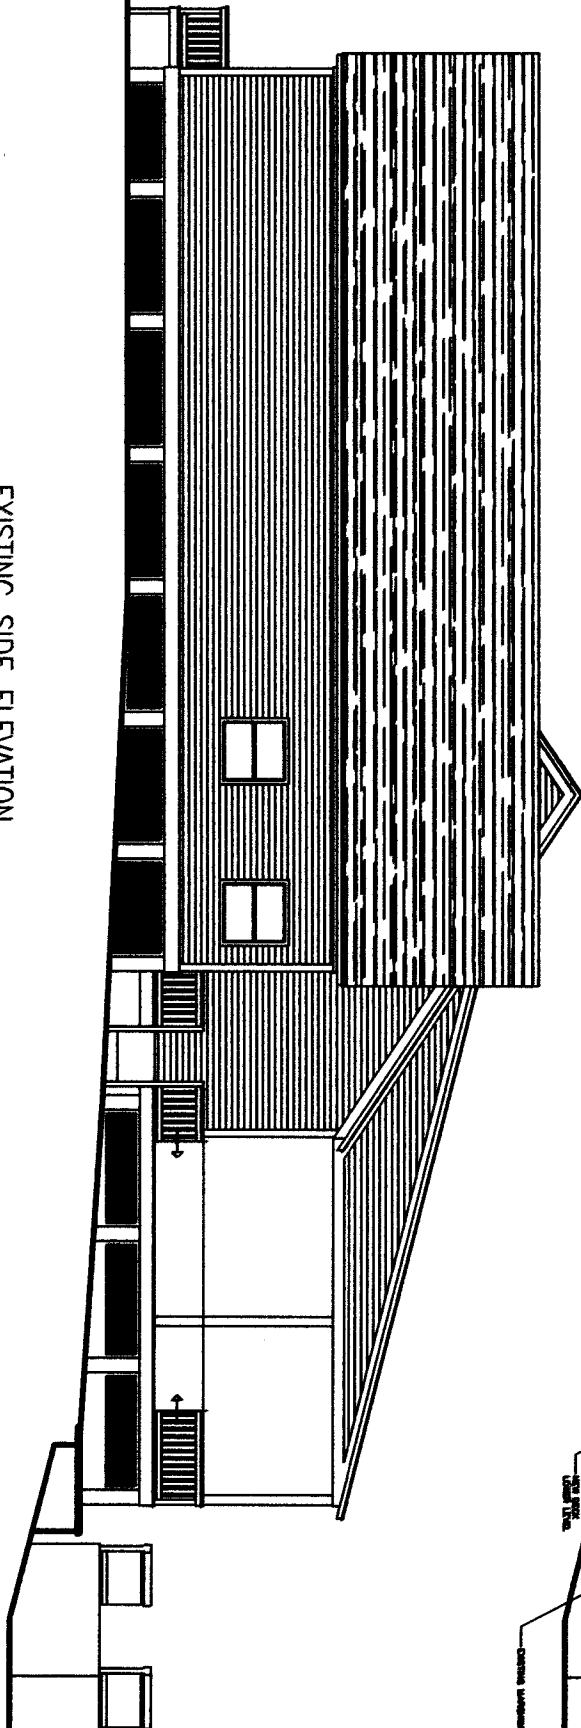

REVISED SIDE ELEVATION

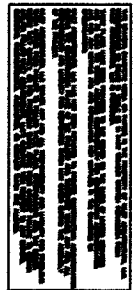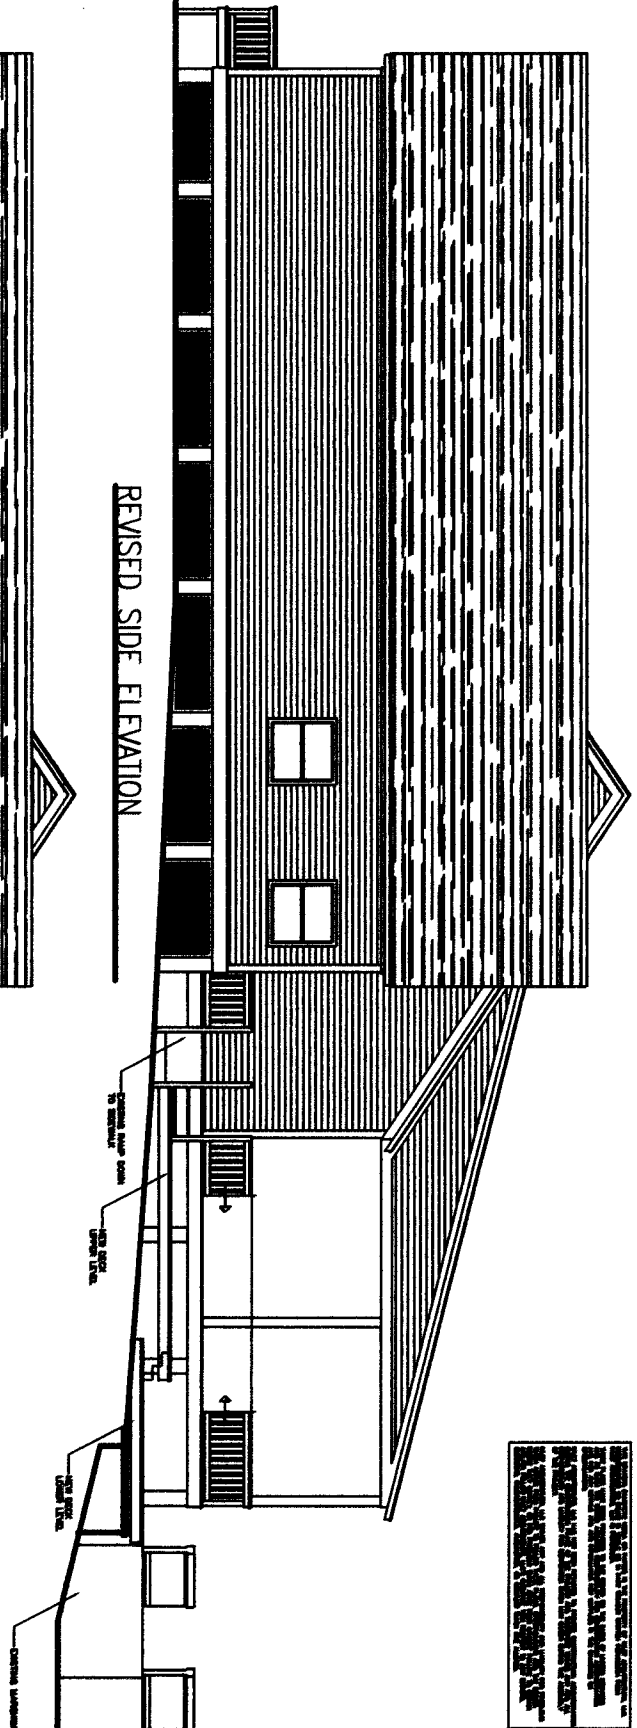

0024-14-080-S


THIS DRAWING IS THE PROPERTY OF INLET ARCHITECTURE, LLC AND MAY NOT BE USED IN WHOLE OR IN PART WITHOUT WRITTEN CONSENT OF THE ARCHITECT

2	DATE	BY

**A Deck Addition for
Dead Dog Saloon**
Highway 17, Beaufort, Beaufort, NC




DATE	BY

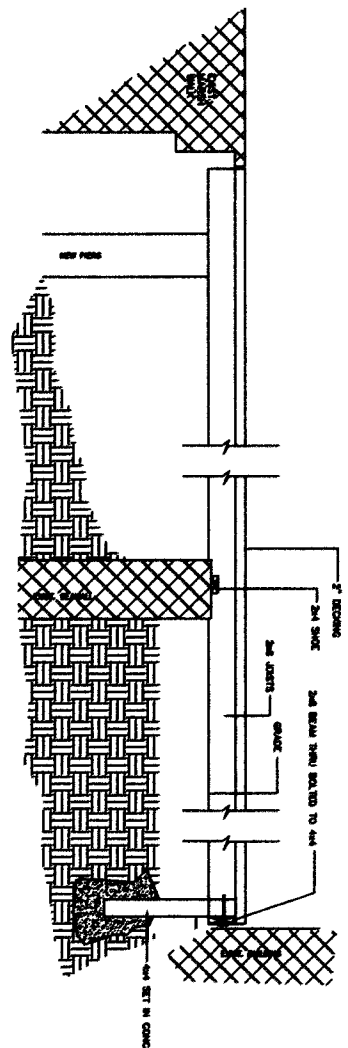

SCHEMATIC SECTION THRU NEW DECK
FILE


NOTE: CONFIRM CONNECTIONS WITH STRUCTURAL PLANS

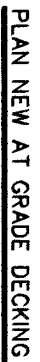


UCRM-14-080-S

**A Deck Addition for
Dead Dog Saloon**
Highway 17 direction, towards exit, SC



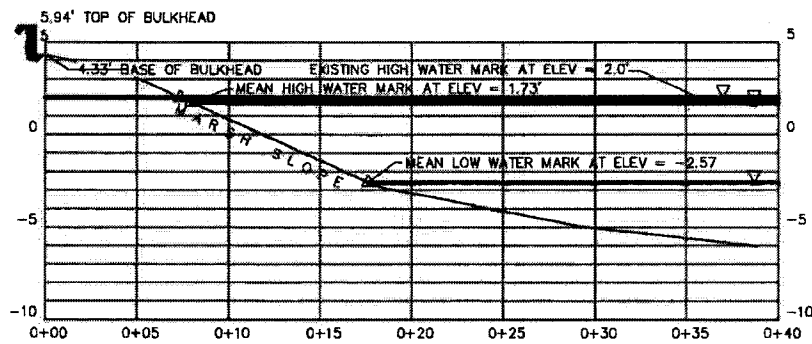

SECTION "A-A" PROFILE
SCALE: HORZ = 1" = 10'
VERT = 1" = 10'

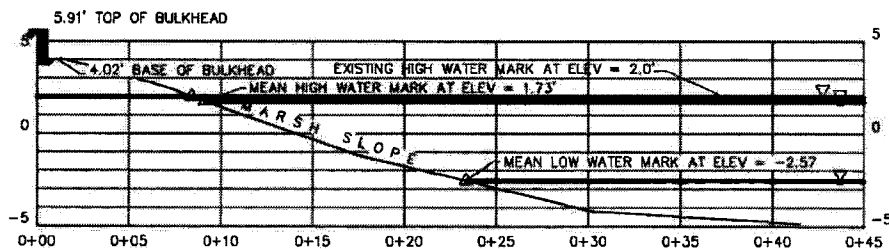

SECTION "B-B" PROFILE
SCALE: HORZ = 1" = 10'
VERT = 1" = 10'

PETER HAENTJESM
843-458-2752



ASBUILT SURVEY OF A PORTION OF A CREEKSIDE
FRONTAGE ALONG LOTS 13, 14, AND 15 OF THE
LOVERS LANE LOTS LOCATED IN MURRELLS INLET,
GEORGETOWN COUNTY, SOUTH CAROLINA
PREPARED FOR

**K9 CUISINE DBA
DEAD DOG SALOON**

Michael S. Culler III

MICHAEL S. CULLER, III
S.C. REGISTERED LAND SURVEYOR No. 29114

DCRM-14-080-S

JANUARY 9, 2014
SHEET 3 OF 3
DWG = LS-12633



PETER HAENTJESM
843-458-2752



ASBUILT SURVEY OF A PORTION OF A CREEKSIDE
FRONTAGE ALONG LOTS 13, 14, AND 15 OF THE
LOVERS LANE LOTS LOCATED IN MURRELLS INLET,
GEORGETOWN COUNTY, SOUTH CAROLINA
PREPARED FOR

**K9 CUISINE DBA
DEAD DOG SALOON**

Michael S. Culler, III

MICHAEL S. CULLER, III
S.C. REGISTERED LAND SURVEYOR No. 29114

OCRM-14-080S

JANUARY 9, 2014
SHEET 1 OF 3
DWG = LS-12633